

**Tree Preservation Order**

**Town and Country Planning Act 1990**

**The St Albans City and District Council Tree Preservation Order No 1601 20<sup>th</sup> July 2016, 36, 40, 46 Sandpit Lane & 2 Monks Horton Way, St Albans**

The St Albans City and District Council, in exercise of the powers conferred on them by section 198 of the Town and Country Planning Act 1990 make the following Order—

**Citation**

1. This Order may be cited as TPO 1601, 36, 40, 46 Sandpit Lane & 2 Monks Horton Way, St Albans 2016.

**Interpretation**

2.— (1) In this Order “the authority” means the St Albans City and District Council.

(2) In this Order any reference to a numbered section is a reference to the section so numbered in the Town and Country Planning Act 1990 and any reference to a numbered regulation is a reference to the regulation so numbered in the Town and Country Planning (Tree Preservation)(England) Regulations 2012.

**Effect**

3.— (1) Subject to article 4, this Order takes effect provisionally on the date on which it is made.

(2) Without prejudice to subsection (7) of section 198 (power to make tree preservation orders) or subsection (1) of section 200 (tree preservation orders: Forestry Commissioners) and, subject to the exceptions in regulation 14, no person shall—

- (a) cut down, top, lop, uproot, wilfully damage, or wilfully destroy; or
- (b) cause or permit the cutting down, topping, lopping, uprooting, wilful damage or wilful destruction of,

any tree specified in the Schedule to this Order except with the written consent of the authority in accordance with regulations 16 and 17, or of the Secretary of State in accordance with regulation 23, and, where such consent is given subject to conditions, in accordance with those conditions.

**Application to trees to be planted pursuant to a condition**

4. In relation to any tree identified in the first column of the Schedule by the letter “C”, being a tree to be planted pursuant to a condition imposed under paragraph (a) of section 197 (planning permission to include appropriate provision for preservation and planting of trees), this Order takes effect as from the time when the tree is planted.

Dated this day 20<sup>th</sup> of July 2016

[Signed on behalf of the St Albans City and District Council

.....  


Authorised by the Council to sign in that behalf]

CONFIRMATION OF ORDER


~~[This Order was confirmed by St Albans City and District Council without modification on the day of~~

~~2016~~

OR

[This Order was confirmed by the St Albans City and District Council, subject to the modifications indicated by T2 removal and T6 change of species, on the 13<sup>th</sup> day of December 2016

[Signed on behalf of the St Albans City and District Council

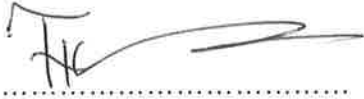

Authorised by the Council to sign in that behalf]

[DECISION NOT TO CONFIRM ORDER

[A decision not to confirm this Order was taken by St Albans City and District Council on the day of 2016

[Signed on behalf of the St Albans City and District Council

.....

Authorised by the Council to sign in that behalf]

[VARIATION OF ORDER

[This Order was varied by the St Albans City and District Council on the day of 2016 by a variation order under reference number [insert reference number to the variation order] a copy of which is attached]

[Signed on behalf of the St Albans City and District Council

.....

Authorised by the Council to sign in that behalf]


[REVOCATION OF ORDER

[This Order was revoked by the St Albans City and District Council on the day of 2016

[Signed on behalf of the St Albans City and District Council

.....

Authorised by the Council to sign in that behalf]

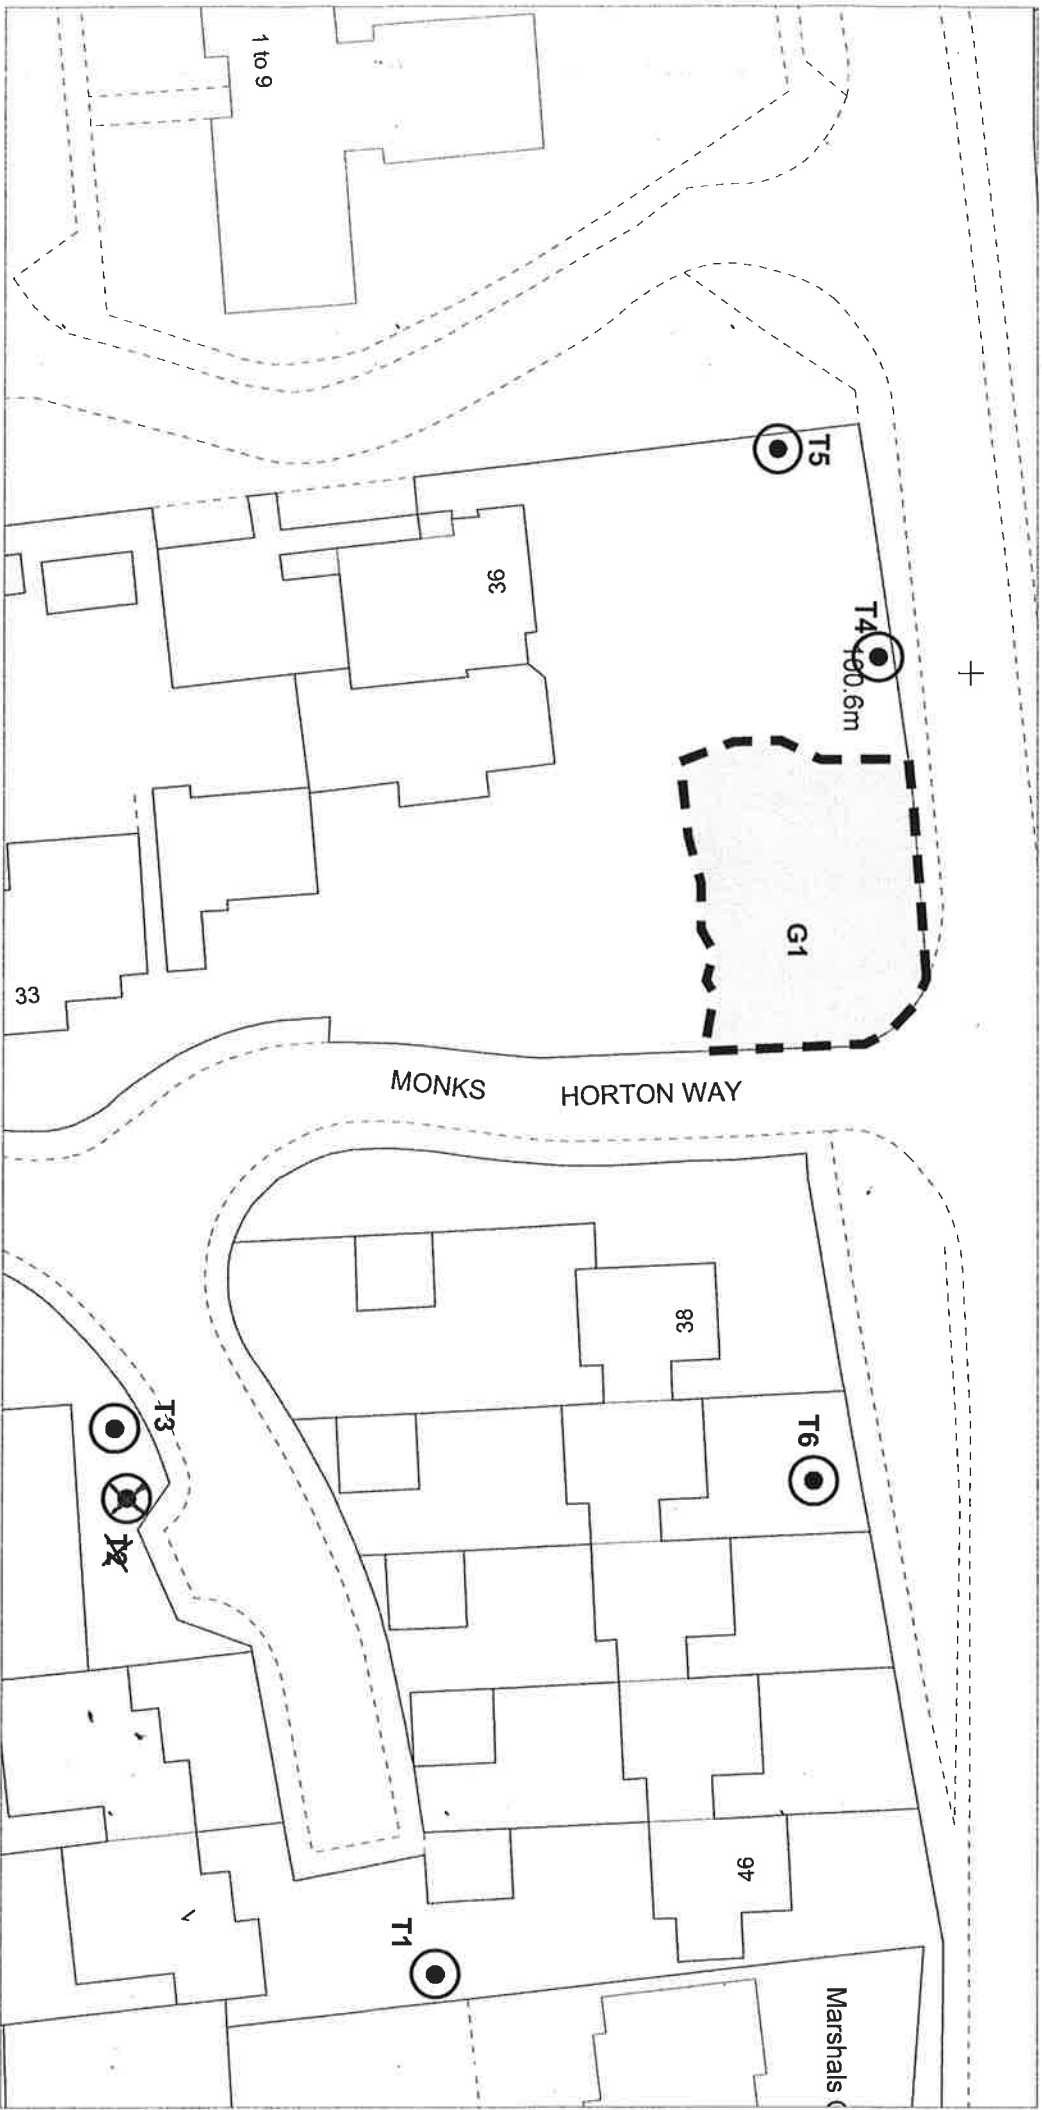

Scale: - 1:500

Drawn By: J.A

Date: 20th July 2016



Location: 36, 40, 46 Sandpitt Lane & 2 Monks Horton Way, St Albans

Schedule: Tree Preservation Order No. 1601

Individual Trees: T1 - Lime, T2 - Copper Beech, T3 - Silver Birch, T4 - Cherry,  
T5 - Cypress, T6 - ~~Grub-Apple~~ Amelanchier

Groups: G1 - 5 Hornbeam, 2 Horse Chestnut, 1 Lime

Woodlands: None      Areas: None



Dated this: 20th July 2016

*Chris Syme*

Authorised by the Council to sign in that behalf

# SCHEDULE

## SPECIFICATION OF TREES

### Trees specified individually (encircled in black on the map)

Reference on map	Description	Situation
T1	Lime	Rear Driveway
<del>T2</del>	<del>Copper Beech</del>	<del>Front Garden</del> (Felled 2016, awaiting replant)
T3	Silver Birch	Front Garden
T4	Cherry	Front Garden/Next to fence
T5	Cypress	Next to Driveway
T6	<del>Crab Apple</del> <i>Amelanchier</i>	Front Garden

### Trees specified by reference to an area (within a dotted black line on the map)

Reference on map	Description	Situation
None		

### Groups of trees (within a broken black line on the map)

Reference on map	Description	Situation
G1	5 Hornbeam, 2 Horse Chestnut, 1 Lime	Rear Garden/Area between fences

### Woodlands (within a continuous black line on the map)

Reference on map	Description	Situation
None		