
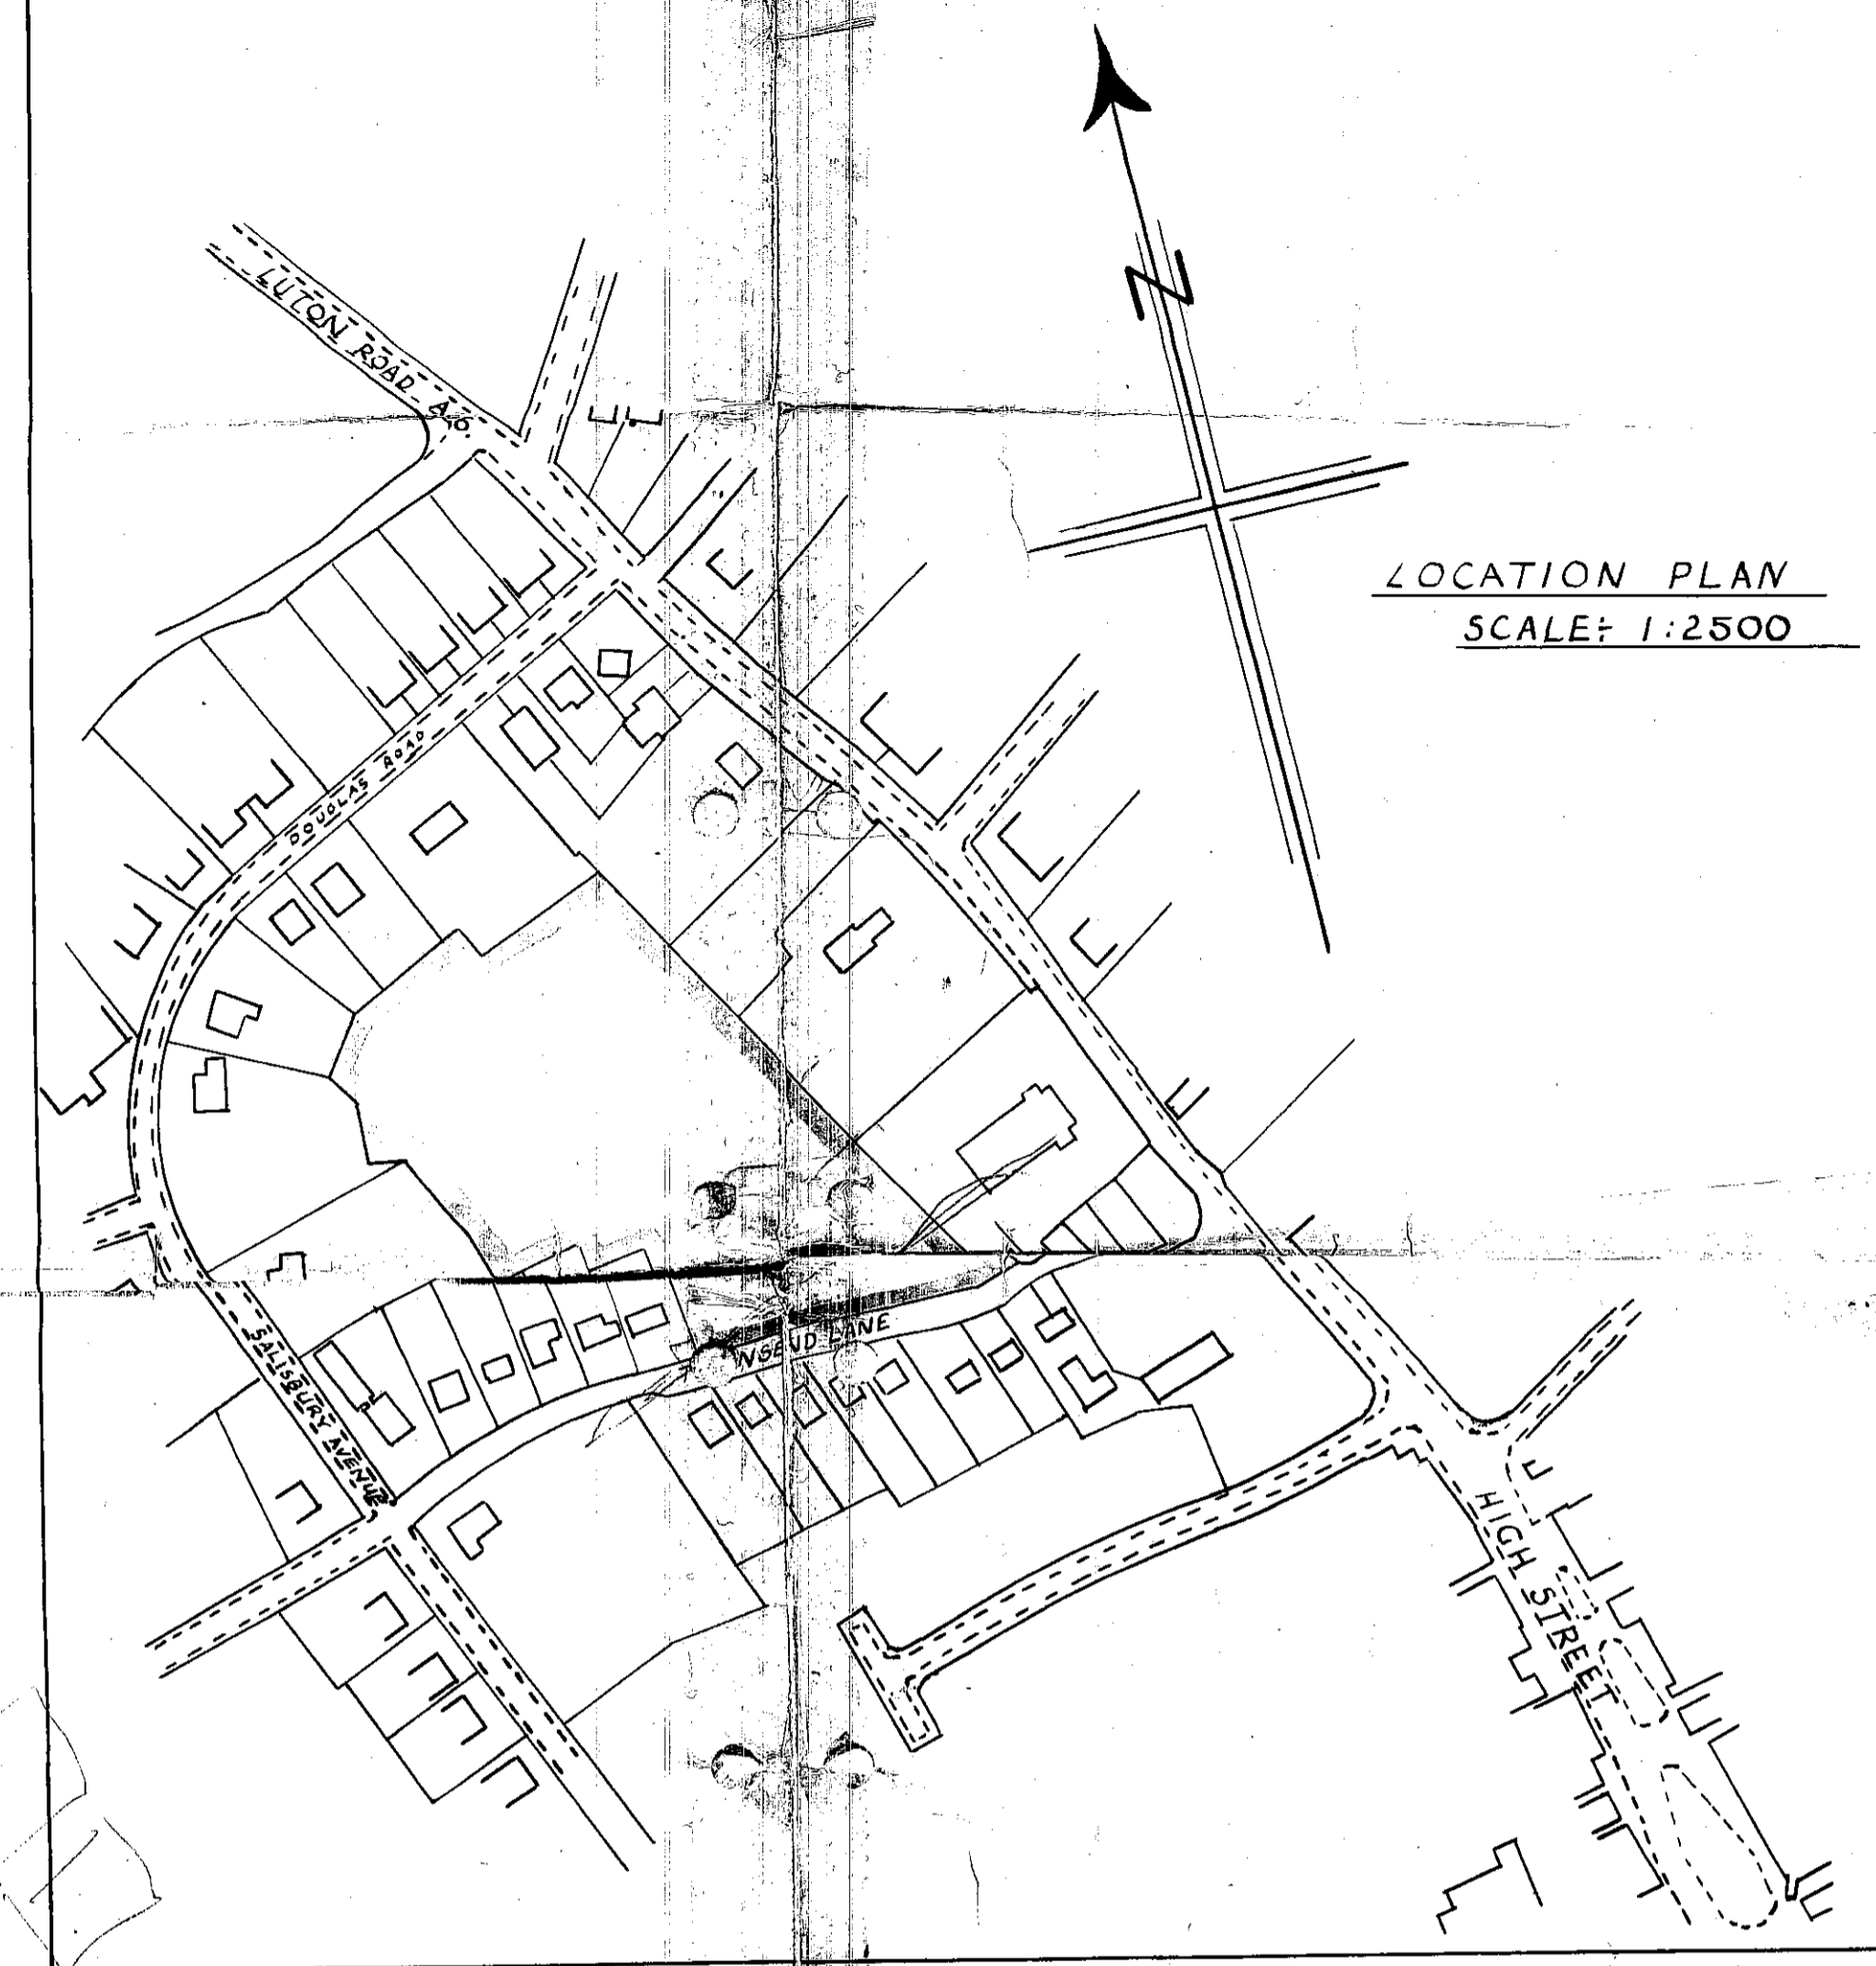


URBAN DISTRICT OF HARPENDEN
 TREE PRESERVATION (APLINS CLOSE, HARPENDEN) (No.3) ORDER, 1964

D. G. BEST
 Clerk of the Council.

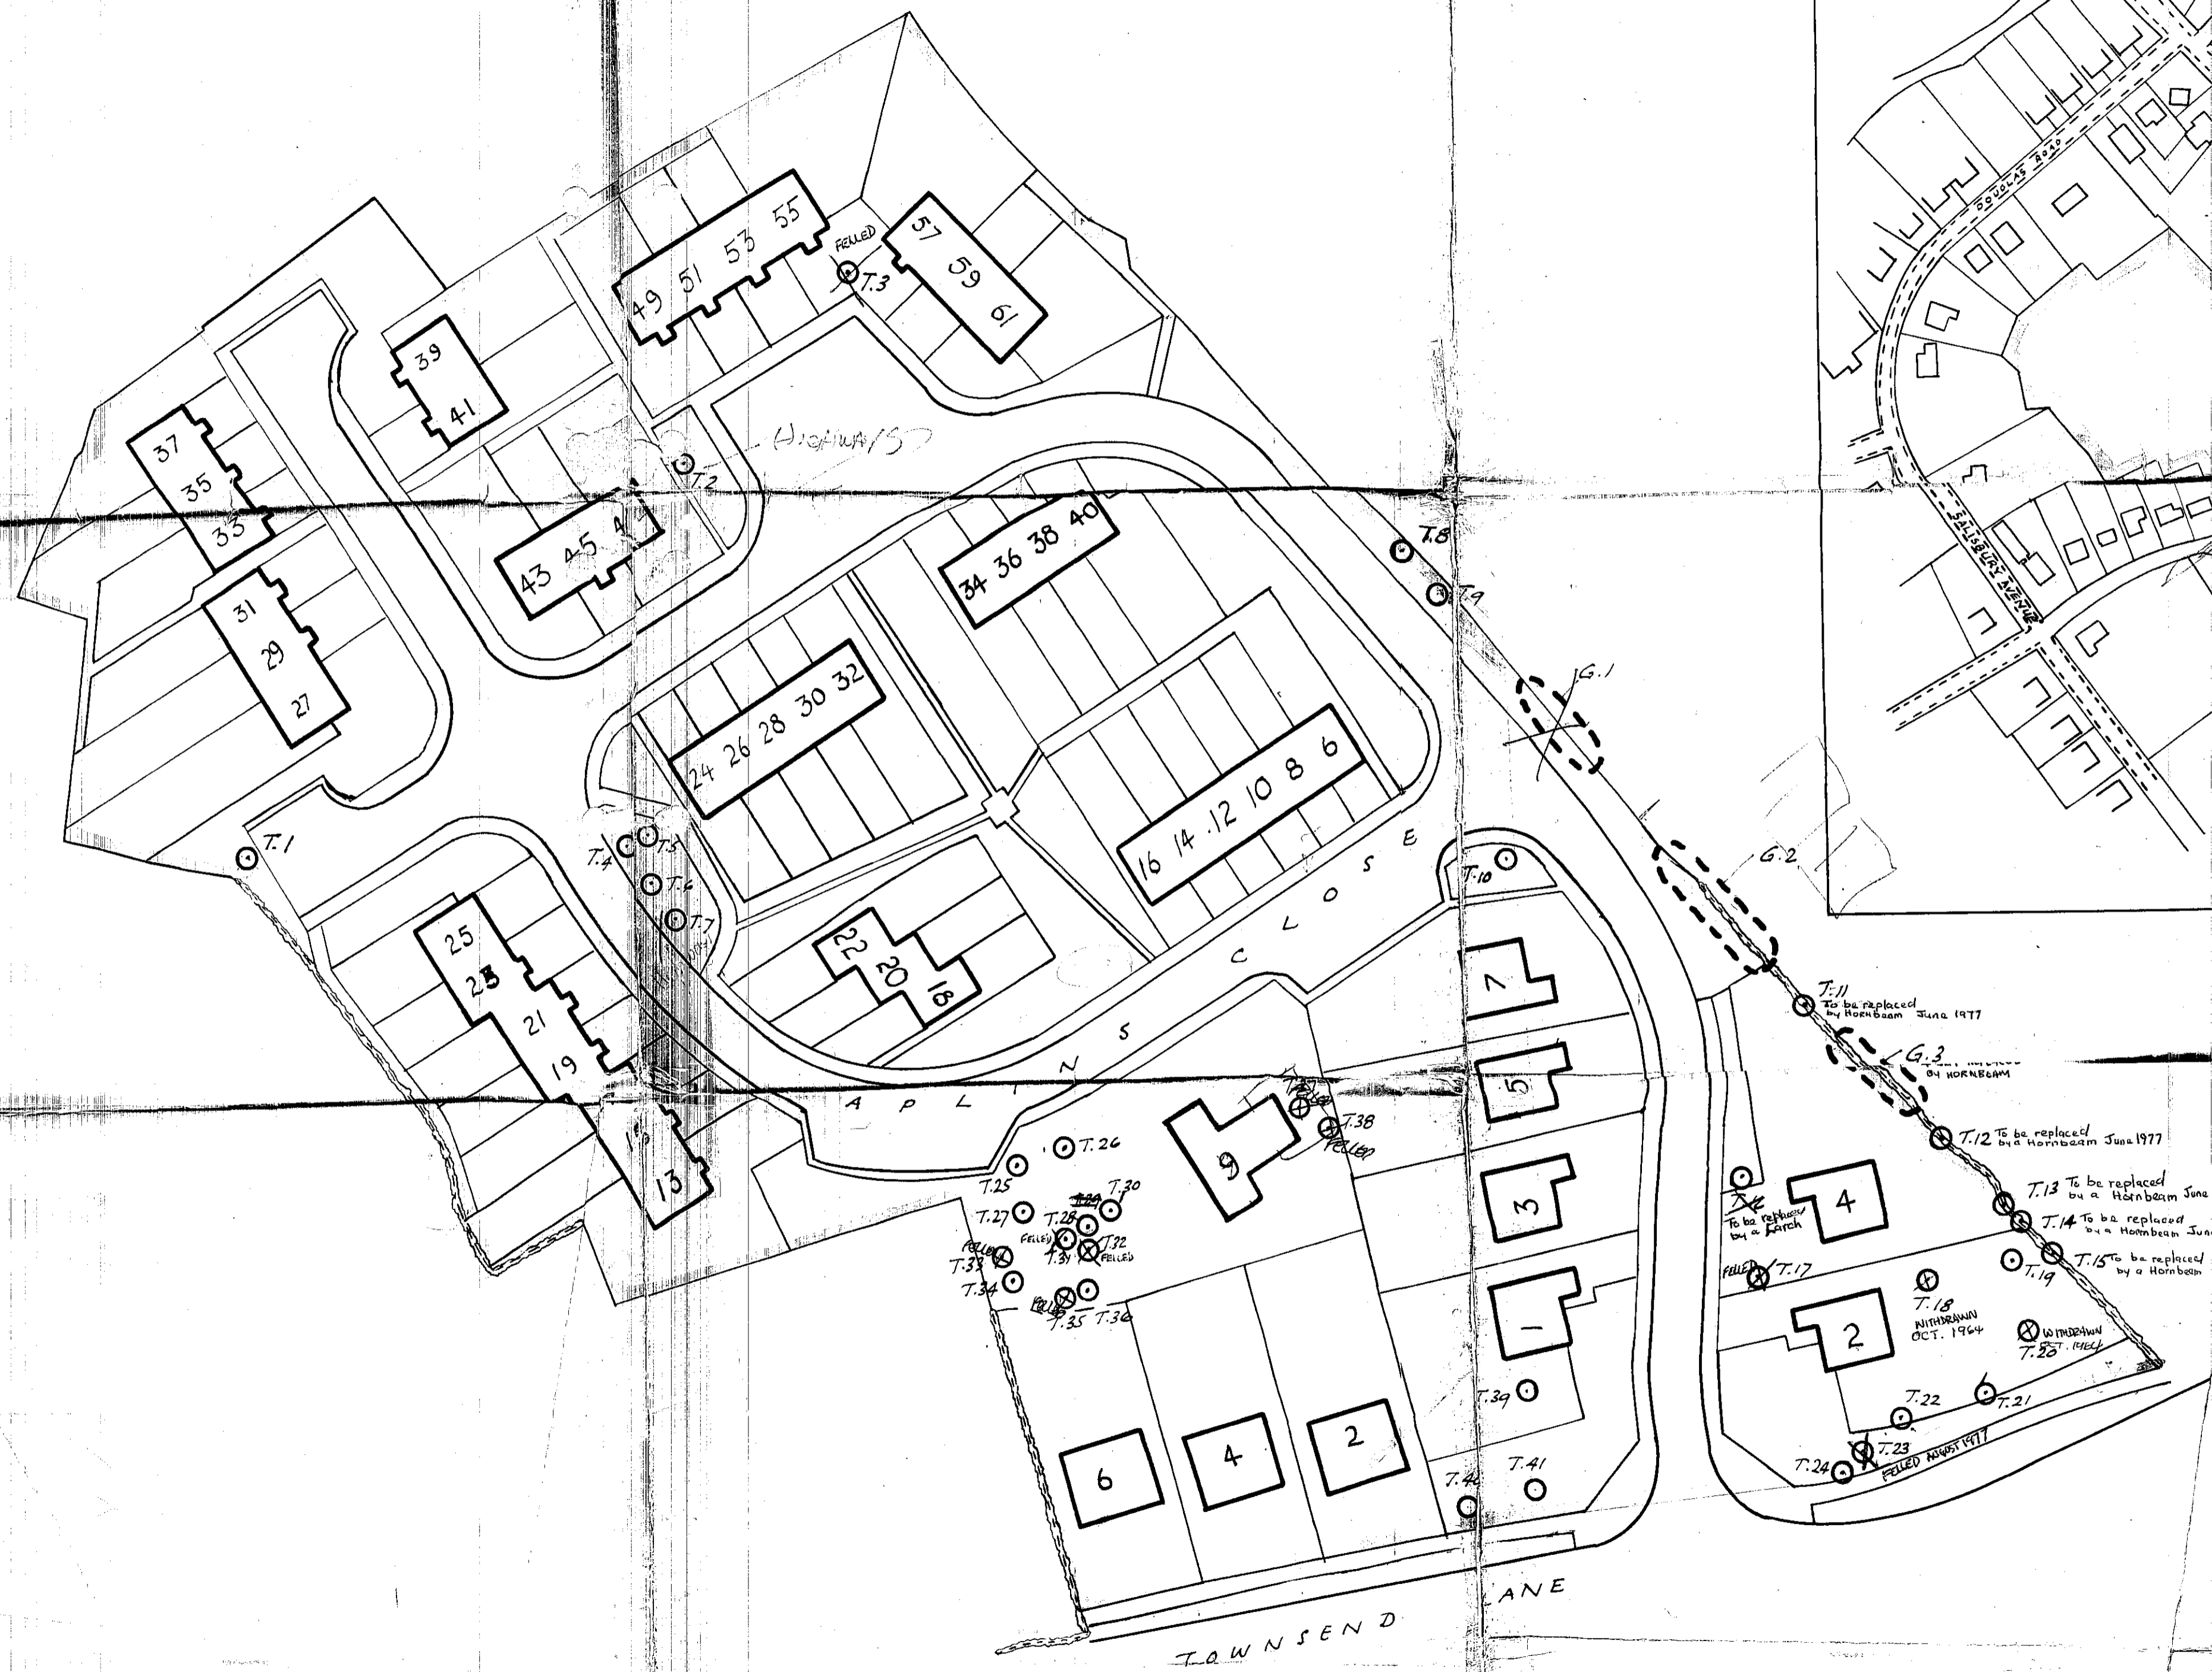

LOCATION PLAN
 SCALE: 1:2500

HARPENDEN U.D.O.
 SURVEYORS DEPT.
 RECEIVED
 28 JUL 1964

HARPENDEN URBAN DISTRICT COUNCIL ENGINEER & SURVEYOR - H. RETTINGALE. A.M.I.C.E. A.R.I.C.S. A.M.I. Mun. E.		
SCALE :- 1:500	DRAWN TRACED CHECKED DATE 2/64	DRG. No. 687

178 Rectory Close
 rear of Aplins Close

Dated 24th August 19 64 .

Harpenden Urban District Council

TOWN AND COUNTRY PLANNING ACT, 1962.

Copy
TREE PRESERVATION ORDER

relating to

lands at Aplins Close, Harpenden, Herts.

TREE PRESERVATION / ORDER, 1964**TOWN AND COUNTRY PLANNING ACT, 1962.**

The URBAN DISTRICT COUNCIL of HARPENDEN in the County of Hertford acting on behalf of the County Council of the administrative County of Hertford (in this Order called "the authority") in pursuance of the powers conferred in that behalf by Section 29 of the Town and Country Planning Act, 1962, and subject to the provisions of Section 13 of the Forestry Act, 1951, hereby make the following Order :—

1. In this Order :—

"the Act" means the Town and Country Planning Act, 1962;

"owner" means the owner in fee simple, either in possession or who has granted a lease or tenancy of which the unexpired portion is less than three years; a lessee (including a sub-lessee) or tenant in possession, the unexpired portion of whose lease or tenancy is three years or more and a mortgagee in possession; and

"the Minister" means the Minister of Housing and Local Government.

2.—Subject to the provisions of this Order and to the exemptions specified in the Second Schedule hereto, no person shall, except with the consent of the authority and in accordance with the conditions, if any, imposed on such consent, cut down, top, lop, or wilfully destroy or cause or permit the cutting down, topping, lopping or wilful destruction of any tree specified in the First Schedule hereto or comprised in a group of trees ~~or in a woodland~~ therein specified, the position of which trees ^{and} groups of trees ~~and woodlands~~ is defined in the manner indicated in the said First Schedule ~~[on the map annexed hereto]~~ ~~[on the map marked Urban District of Harpenden signed by the Clerk of the Authority and deposited for inspection at Tree Preservation (Aplins Close, Harpenden) (No.3) Order, 1964 signed by the Clerk of the Council for the map marked Harpenden Urban District / signed by the Clerk of the Authority and deposited for inspection at the Council Offices, Harpenden Hall, Harpenden, aforesaid and a certified copy of which has been similarly deposited at]~~, which map shall, for the purpose of such definition as aforesaid, prevail where any ambiguity arises between it and the specification in the said First Schedule.

3.—An application for consent made ~~to the authority~~ under article 2 of this Order shall be in writing stating the reasons for making the application, and shall by reference if necessary to a plan specify the trees to which the application relates, and the operations for the carrying out of which consent is required.

4.—(1) Where an application for consent is made ~~to the authority~~ under this Order, the authority may grant such consent either unconditionally, or subject to such conditions (including conditions requiring the replacement of any tree by one or more trees on the site or in the immediate vicinity thereof), as the authority may think fit, or may refuse consent.

~~Provided that where the application relates to any woodland specified in the First Schedule to this Order the authority shall grant consent so far as accords with the principles of good forestry, except where, in the opinion of the authority, it is necessary in the interests of amenity to maintain the special character of the woodland or the woodland character of the area, and shall not impose conditions on such consent requiring replacement or replanting.~~

(2) The authority shall keep a register of all applications for consent under this Order containing information as to the nature of the application, the decision of the authority thereon, any compensation awarded in consequence of such decision ~~and any directions as to replanting of woodlands~~; and every such register shall be available for inspection by the public at all reasonable hours.

5.—Where the authority refuse consent under this Order or grant such consent subject to conditions they may when refusing or granting consent certify in respect of any trees for which they are so refusing or granting consent that they are satisfied :—

- (a) that the refusal or condition is in the interests of good forestry; or
- (b) ~~in the case of trees other than trees comprised in woodlands~~, that the trees have an outstanding or special amenity value.

~~6. (1) Where consent is granted under this Order to fell any part of a woodland then unless :~~

- (a) such consent is granted for the purpose of enabling development to be carried out in accordance with a permission to develop land under Part III of the Act, or
- (b) the authority with the approval of the Minister dispense with replanting,

~~the authority shall give to the owner of the land on which that part of the woodland is situated a direction in writing specifying the manner in which and the time within which he shall replant such land and where such a direction is given and the part is felled the owner shall subject to the provisions of this Order replant the said land in accordance with the direction.~~

NOTE.—If it is desired to fell any of the trees included in this Order whether included as trees, groups of trees or woodlands and the trees are trees for the felling of which a licence is required under the Forestry Act, 1951, application must be made *not* to the authority for consent under this Order but to the Forestry Commissioners for a licence under that Act (*see* Forestry Act, 1951, section 13 (1)).

~~(2) Any direction given under paragraph (1) of this Article may include requirements as to:~~

- (a) species ;
- (b) number of trees per acre ;
- (c) the erection and maintenance of fencing necessary for protection of the replanting ;
- (d) the preparation of ground, draining, removal of brushwood, lop and top ; and
- ~~(e) protective measures against fire.~~

6. ~~7.~~—The provisions set out in the Third Schedule to this Order, being provisions of Parts III and VII of the Act adapted and modified for the purposes of this Order, shall apply in relation thereto.

7. ~~8.~~—Subject to the provisions of this Order, any person who has suffered damage or has incurred expenditure in consequence of any refusal of consent under this Order or of any grant of any such consent subject to conditions, shall, if he makes a claim on the authority within the time and in the manner prescribed by this Order, be entitled to recover from the authority compensation in respect of such damage or expenditure.

Provided that no compensation shall be payable in respect of damage suffered or expenditure incurred by reason of such refusal or grant of consent in the case of any trees the subject of a certificate in accordance with Article 5 of this Order.

8. ~~9.~~—In assessing compensation payable under the last preceding Article or under Section 118 of the Act as applied by this Order, account shall be taken of:—

- (a) any compensation or contribution which has been paid in respect of the same trees under the terms of this or any other Tree Preservation Order under Section 29 of the Act or under the terms of any Interim Preservation Order made under Section 8 of the Town and Country Planning (Interim Development) Act, 1943, or any compensation which has been paid or which could have been claimed under any provision relating to the preservation of trees or protection of woodlands contained in an operative scheme under the Town and Country Planning Act, 1932, and
- (b) any injurious affection to any land of the owner which would result from the felling of the trees the subject of the claim.

9. ~~10.~~—(1) A claim for compensation under this Order shall be in writing and shall be made by serving it on the authority such service to be effected by delivering the claim at the offices of the authority addressed to the Clerk thereof or by sending it by prepaid post so addressed.

(2) The time within which any such claim shall be made as aforesaid shall be a period of twelve months from the date of the decision of the authority, or of the Minister, as the case may be, or where an appeal has been made to the Minister against the decision of the authority, from the date of the decision of the Minister on the appeal.

10. ~~11.~~—Any question of disputed compensation shall be determined in accordance with the provisions of Section 128 of the Act.

11. ~~12.~~—Any person contravening the provisions of this Order is guilty of an offence under subsection (1) of Section 62 of the Act and liable on summary conviction to a fine not exceeding fifty pounds ; and if in the case of a continuing offence the contravention is continued after conviction he is guilty of a further offence thereunder and liable on summary conviction to an additional fine not exceeding forty shillings for every day on which the contravention is so continued.

(5) Before determining an appeal under this section, the Minister shall, if either the appellant or the authority so desire, afford to each of them an opportunity of appearing before, and being heard by, a person appointed by the Minister for the purpose.

(7) The decision of the Minister on any appeal under this section shall be final.

24. Appeal in default of decision.—Where an application for consent under the Order is made to the authority, then unless within two months from the date of receipt of the application, or within such extended period as may at any time be agreed upon in writing between the applicant and the authority, the authority either—

- (a) give notice to the applicant of their decision on the application ; or]
- (b) give notice to him that the application has been referred to the Minister in accordance with directions given under section 22 of this Act ;

the provisions of the last preceding section shall apply in relation to the application as if the consent to which it relates had been refused by the authority, and as if notification of their decision had been received by the applicant at the end of the said period of two months, or at the end of the said extended period, as the case may be.

27. Power to revoke or modify the consent under the order.—(1) If it appears to the authority that it is expedient to revoke or modify any consent under the Order granted on an application made under Article 3 of the Order, the authority may by order revoke or modify the consent to such extent as they consider expedient.

(2) An order under this section shall not take effect unless it is confirmed by the Minister ; and the Minister may confirm any such order submitted to him either without modification or subject to such modifications as he considers expedient.

(3) Where an authority submit an order to the Minister for his confirmation under this section, the authority shall furnish the Minister with a statement of their reason for making the order and shall serve notice on the owner of the land affected, and on any other person who in their opinion will be affected by the order, and if within the period of twenty-eight days from the service thereof any person on whom the notice is served so requires, the Minister, before confirming the order, shall afford to that person, and to the authority, an opportunity of appearing before, and being heard by, a person appointed by the Minister for the purpose.

(4) The power conferred by this section to revoke or modify a consent may be exercised at any time before the operations for which consent has been given have been completed.

Provided that the revocation or modification of consent shall not affect so much of those operations as has been previously carried out.

(5) Where a notice has been served in accordance with the provisions of subsection (3) of this section, no operations or further operations as the case may be, in pursuance of the consent granted, shall be carried out pending the decision of the Minister under subsection (2) of this section.

118. Supplementary provisions as to revocation and modification.—(1) Where any person is affected by an order under section 27 of this Act, or by a notice served on him under subsection (3) of the said section in a case where the order is not confirmed then, if, on a claim made to the authority within the time and in the manner prescribed by Article 10 of the Order, it is shown that he—

- (a) has incurred expenditure in carrying out work which is rendered abortive by the revocation, or modification, or stay of operations, as the case may be, or
- (b) has otherwise sustained loss or damage which is directly attributable to the revocation, modification, or stay of operations,

the authority shall pay to that person compensation in respect of that expenditure, loss or damage.

(2) For the purposes of this section any expenditure incurred on matters preparatory to acting on the consent shall be taken to be included in the expenditure incurred in carrying out that work.

(3) Subject to the last preceding subsection, no compensation shall be paid under this section in respect of any work carried out in the period after the making of the Order and before the grant of consent which is revoked or modified, or in respect of any other loss or damage (not being loss or damage consisting of depreciation of the value of an interest in land) arising out of anything done or omitted to be done during that period.

GIVEN under the Common Seal of the

Harpenden Urban District Council

the **Twentyfourth** day of

August in the year

nineteen hundred and **sixtyfour**

in the presence of:

..... **L. T. FOWLER**

Chairman

..... **D. G. BEST**

Clerk

FIRST SCHEDULE

No. on Map.	Description.	Situation.
T. 1	Sycamore	} FELLED Felled
T. 2	Beech	
T. 3	Walnut	
T. 4	Corsican Pine	} FELLED TO BE REPLACED 15-8-24
T. 5	"	
T. 6	"	
T. 7	"	
T. 8	Lime	} FELLED REPLACED BY HORNBEAM 9-6-77
T. 9	Lime	
T. 10	Beech	
T. 11	Elm	
T. 12	"	
T. 13	"	
T. 14	"	
T. 15	"	} FELLED TO BE REPLACED BY LARCH 31-5-78
T. 16	Cypress	
T. 17	Cedar	} Permission to fell, 18/1/68
T. 18	Pine WITHDRAWN	
T. 19	Horse Chestnut	} Lands situate at Aplins Close, Harpenden, as shown edged pink on map.
T. 20	Pine WITHDRAWN	
T. 21	Thuja	
T. 22	Wellingtonia	
T. 23	Thuja FELLED 10-8-77	
T. 24	Fir	
T. 25	Pine	
T. 26	"	
T. 27	"	
T. 28	"	
T. 29	Elm	} fell 27/4/37
T. 30	Silver Birch	
T. 31	Pine permission	} FELLED REPLACED WITH SCOTS PINE 30-11-83
T. 32	Elm	
T. 33	Pine	
T. 34	Fir	
T. 35	Silver Birch	} FELLED
T. 36	Pine	
T. 37	" FELLED	} FELLED
T. 38	"	
T. 39	Silver Birch	} FELLED
T. 40	Beech	
T. 41	Weeping Willow	
G. 1	Group containing	} FELLED
	4 Elms	
G. 2	Group containing	} FELLED REPLACED BY HORNBEAMS 9-6-77
	4 Elms	
	1 Sycamore	} FELLED
	2 Lombardy Poplars	
G. 3	Group containing	} FELLED
	8 Lombardy Poplars	

SECOND SCHEDULE

This Order shall not apply so as to require the consent of the authority

- (1) to the cutting down, topping or lopping of any tree that is dying or dead or has become dangerous;
- (2) to the cutting down, topping or lopping of any tree :-
 - (a) in compliance with an obligation imposed by or under an Act of Parliament;
 - (b) in pursuance of the power conferred on the Postmaster-General by virtue of Section 5 of the Telegraph (Construction) Act, 1908;
 - (c) in pursuance of the powers conferred by Section 24 of the Regulation of Railways Act, 1868;
 - (d) for the purpose of preventing or abating a nuisance;

- (e) in the case of a statutory undertaker where the land on which the tree is situated is operational land as defined by the Act and either works on such land cannot otherwise be carried out or the cutting down, topping or lopping is for the purpose of securing safety in the operation of the undertaking ;
- (f) by or at the request of an Electricity Board within the meaning of the Electricity Act, 1947, where such tree obstructs the construction by the Board of any main transmission line or other electric line within the meaning respectively of the Electricity (Supply) Act, 1919 and the Electric Lighting Act, 1882 or interferes or would interfere with the maintenance or working of any such line ;
- (g) where immediately required for the purpose of carrying out development authorised by a planning permission granted on an application made under Part III of the Act, or deemed to have been so granted for any of the purposes of that Part.

THIRD SCHEDULE

Provisions of Parts III and VII of the Act as adapted and modified to apply to this Order.

22. Reference of applications to the Minister.—(1) The Minister may give directions to the authority requiring applications for consent under the Order, to be referred to him instead of being dealt with by the authority.

(2) A direction under this section may relate either to a particular application or to applications of a class specified in the direction.

(3) Any application in respect of which a direction under this section has effect shall be referred to the Minister accordingly.

(4) Where an application for consent under the Order is referred to the Minister under this section, the provisions of Articles 4 and 5 of the Order shall apply as they apply to an application which falls to be determined by the authority.

(5) Before determining an application referred to him under this section the Minister shall, if either the applicant or the authority so desire, afford to each of them an opportunity of appearing before, and being heard by, a person appointed by the Minister for the purpose.

(6) The decision of the Minister on any application referred to him under this section shall be final.

23. Appeals against decisions.—(1) Where an application is made to the authority for consent under the Order and that consent is refused by the authority or is granted by them subject to conditions, or where any certificate ~~or direction~~ is given by the authority, the applicant, if he is aggrieved by their decision on the application, or by any such certificate, ~~or the person directed if he is aggrieved by the direction,~~ may by notice under this section appeal to the Minister.

(2) A notice under this section shall be served in writing within twenty-eight days from the receipt of notification of the decision ~~/certificate, or direction,~~ as the case may be, or such longer period as the Minister may allow.

OR

(4) Where an appeal is brought under this section from a decision ~~/certificate or direction~~ of the authority, the Minister, subject to the following provisions of this section, may allow or dismiss the appeal, or may reverse or vary any part of the decision of the authority, whether the appeal relates to that part thereof or not, or may cancel any certificate ~~, or cancel or vary any direction,~~ and may deal with the application as if it had been made to him in the first instance.

*Here insert any other general or specific exceptions.